

GLADSTONE PLACE ST ALBANS	
SECOND FLOOR	
SQM	157 SQM
SQFT	1,690 SQFT
OPEN PLAN 1400 X 800 DESKS	24
MEETING ROOMS	1
TEAPOINT	1




THINK. DESIGN. BUILD

7 MURRELL GREEN
BUSINESS PARK
LONDON ROAD
RG27 9GR

T. 01252 543097
hello@grey.limited
www.grey.limited


THIS DRAWING IS PROTECTED
UNDER COPYRIGHT.
THIS DRAWING IS NOT TO BE
REPRODUCED IN WHOLE OR
PART UNLESS AUTHORISED BY
GREY
COPYRIGHT
THIS DRAWING IS NOT
TO BE SCALED
THE GENERAL CONTRACTOR IS
TO CHECK ALL DIMENSIONS AND
NOTIFY THE DESIGNERS OF ANY
DISCREPANCIES OR OMISSIONS.

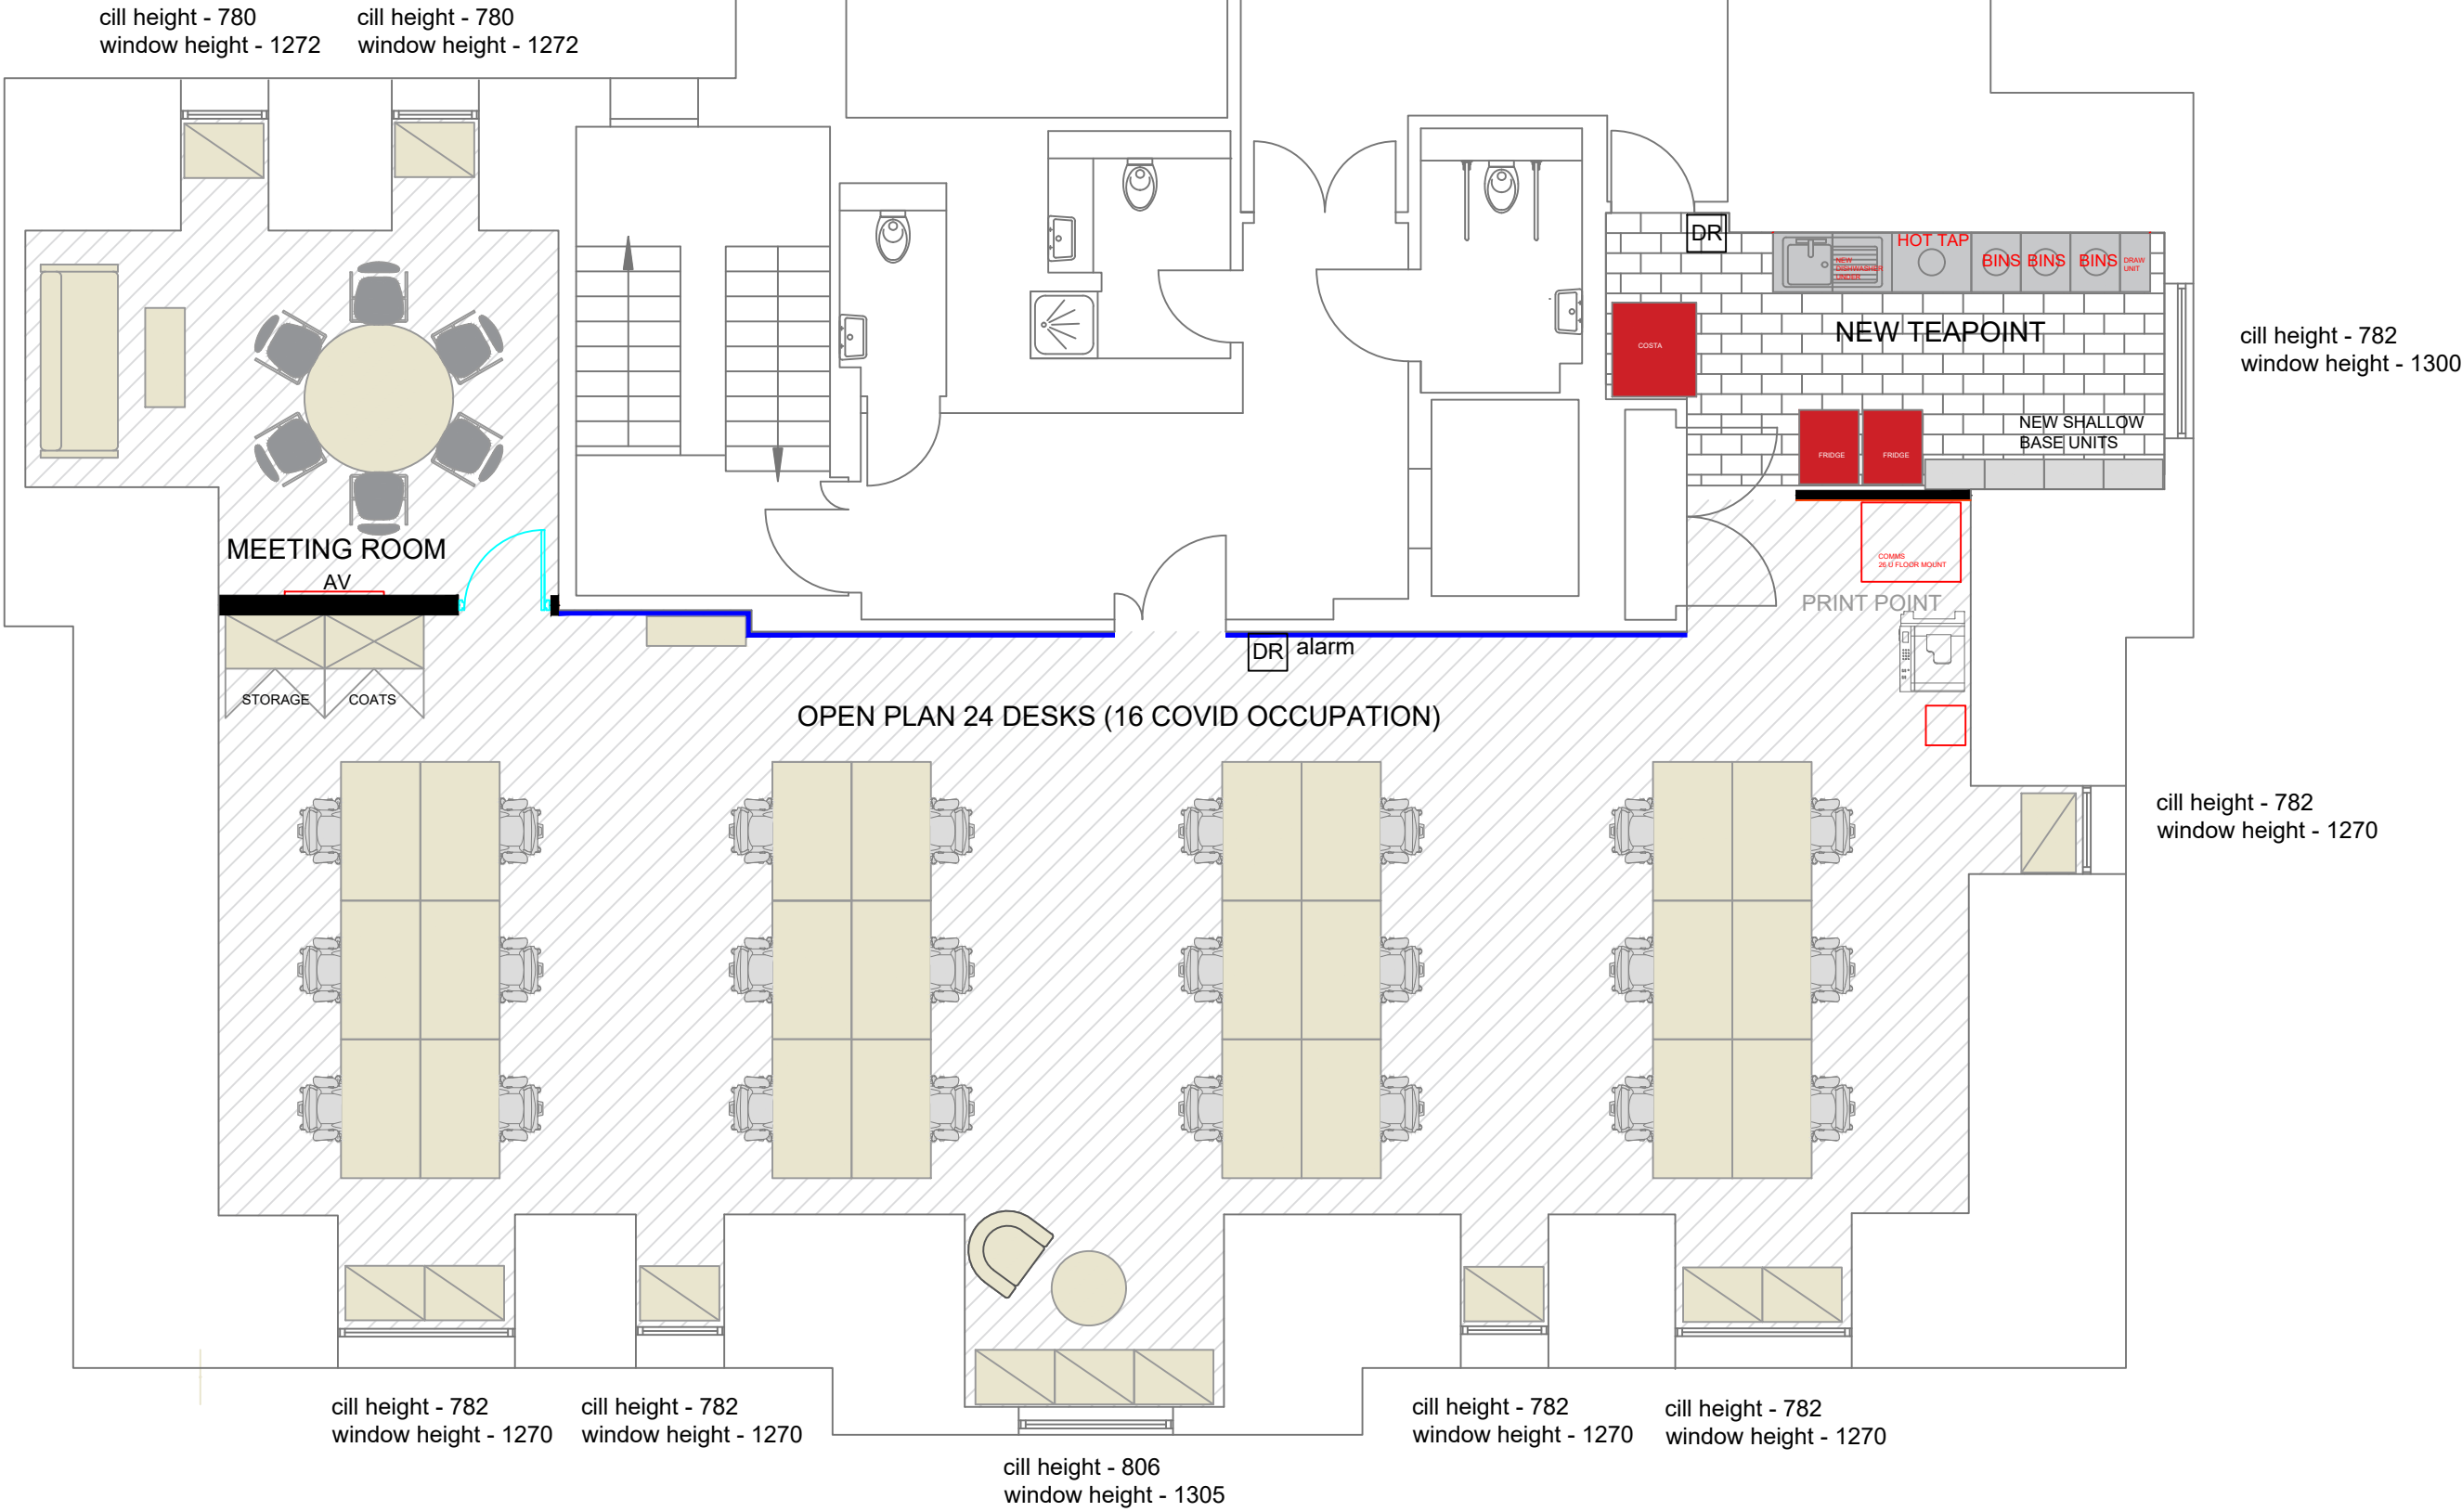

2nd Floor

UPPER MARLBOROUGH ROAD

DATE	REV	REVISIONS	SIGN
CLIENT			
PROJECT GLADSTONE PLACE 36-38 UPPER MARLBOROUGH ROAD ST ALBANS AL1 3UU			
TITLE SECOND FLOOR AS BUILT MARKETING PLAN			
SCALE: 1:50@A1		PROJECT NO: 2020_1664	
DATE: 24/09/2020		DESIGNER: SJJ	
DRAWING: G_1664_GA_ASBUILTS		REV: .	
DRAWING STATUS: AS BUILTS			
CLIENT SIGNATURE:		SIGNOFF DATE:	

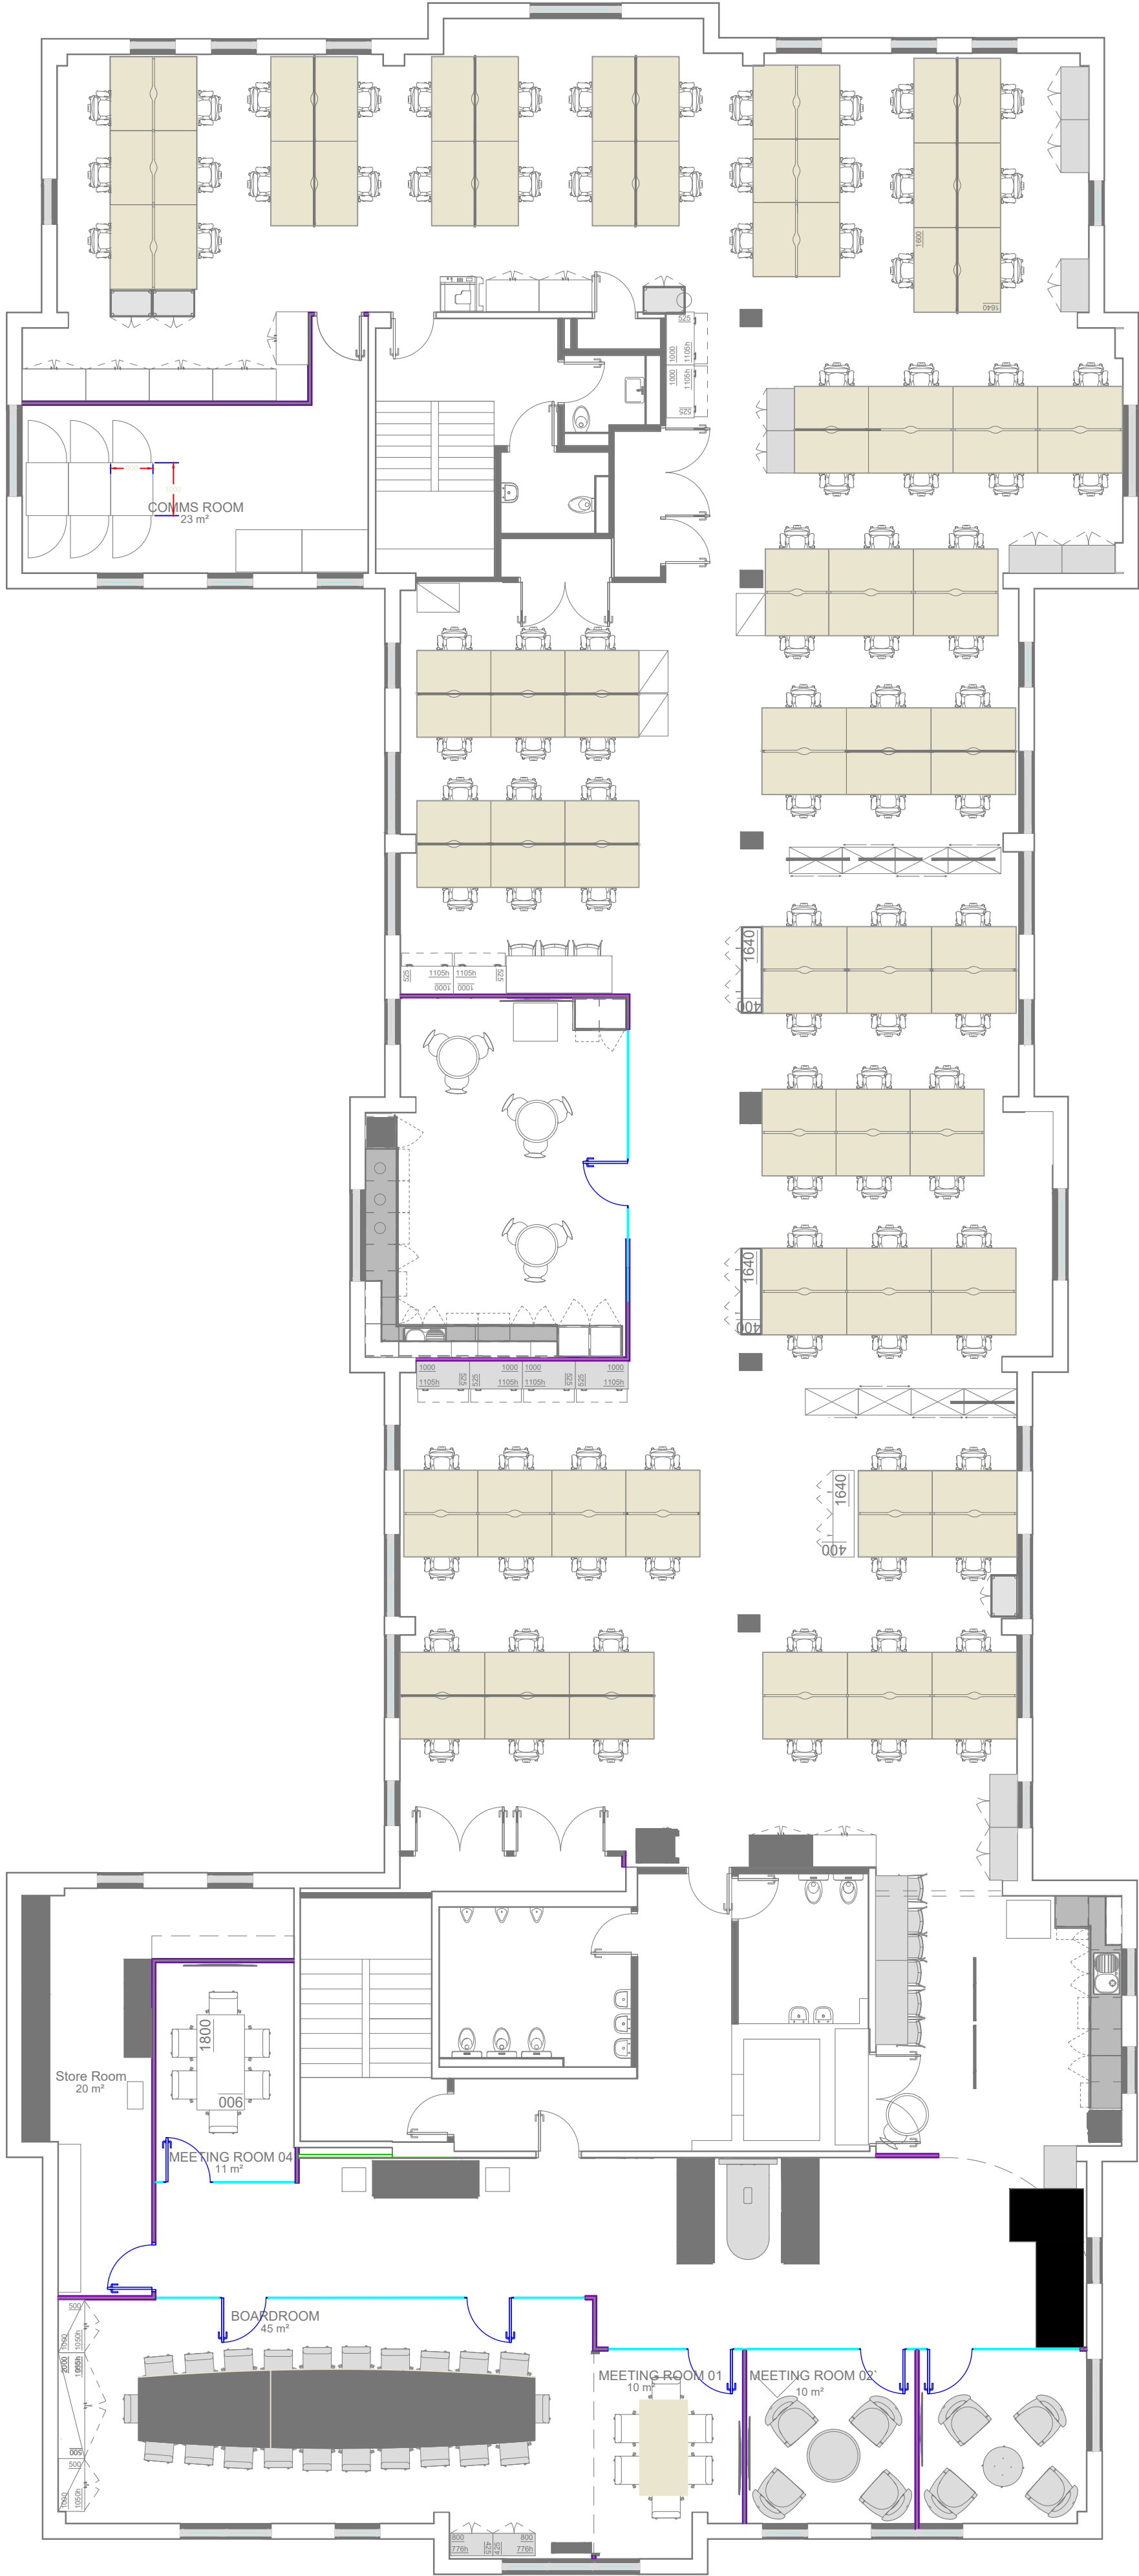

GLADSTONE PLACE ST ALBANS				
FIRST FLOOR				
SQM	648 SQM			
SQFT	6,975 SQFT			
OPEN PLAN (mixed size desks *) DESKS	104	* 1600 x 800	* 1400 x 800	* 1200 x 800
MEETING ROOMS	5	66	34	4
MEETING BOOTH	1			
TEAPOINT	2			
BREAKOUT	1			
PRINT AREA	1			
COMMS ROOM	1			
STORE ROOM	1			



THINK. DESIGN. BUILD

7 MURRELL GREEN
BUSINESS PARK
LONDON ROAD
RG27 9GR

T. 01252 543097
hello@grey.limited
www.grey.limited

THIS DRAWING IS PROTECTED
UNDER COPYRIGHT.
THIS DRAWING IS NOT TO BE
REPRODUCED IN WHOLE OR
PART UNLESS AUTHORISED BY

© COPYRIGHT
THIS DRAWING IS NOT
TO BE SCALED
THE GENERAL CONTRACTOR IS
TO NOTIFY THE DESIGNER OF ANY
DISCREPANCIES OR OMISSIONS.

DATE	REV	REVISIONS	SIGN
CLIENT			
PROJECT GLADSTONE PLACE 36-38 UPPER MARLBOROUGH ROAD ST ALBANS AL1 3UU			
TITLE FIRST FLOOR AS BUILT MARKETING PLAN			
SCALE: 1:50@A1		PROJECT NO: 2019_1579	
DATE: 19/06/2020		DESIGNER: SJJ	
DRAWING: G_1579_GA_ASBUILTS		REV: .	
DRAWING STATUS: PRELIMINARY			
CLIENT SIGNATURE:		SIGNOFF DATE:	